


Notes

The Contractor is to check all dimensions and conditions on site before commencing. Do not scale from this drawing.
This drawing remains the copyright of POZZONI LLP.

Scale Bars TO BE USED ONLY AS GUIDANCE

| | | | | | | |
|--------|----|---|------|------|------|------|
| 1:100 | mm | 0 | 1000 | 2000 | 3000 | 4000 |
| 1:200 | mm | 0 | 500 | 1000 | 1500 | 2000 |
| 1:500 | m | 0 | 5 | 10 | 15 | 20 |
| 1:1250 | m | 0 | 2.5 | 5 | 7.5 | 10 |

KEYPLAN

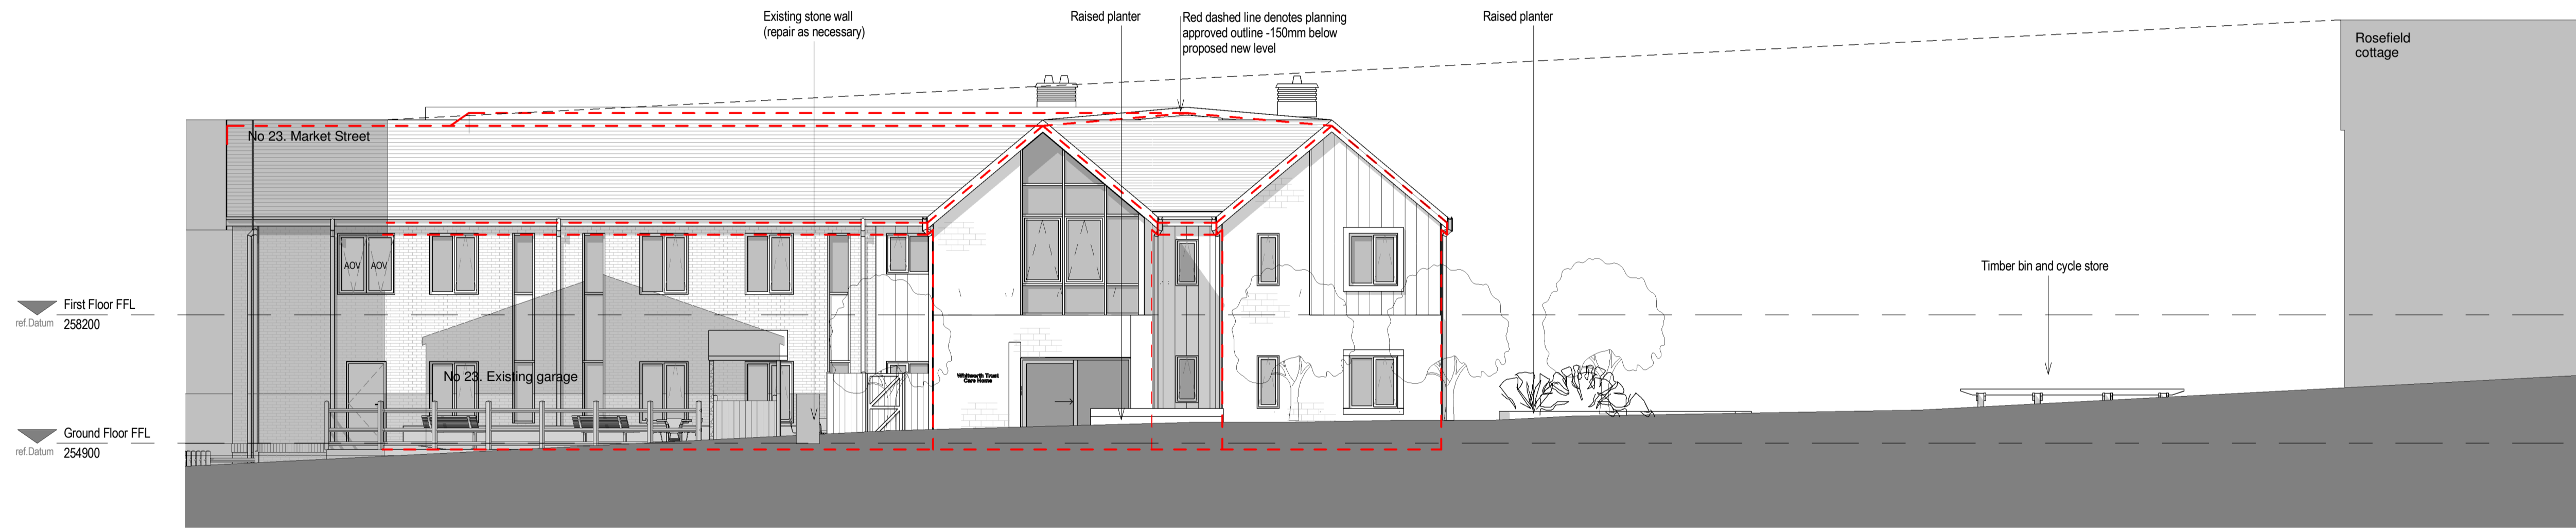

| | | | |
|-----|-----------------------------------|-----|----------|
| Rev | Description | By | Date |
| A | Variation of Condition Submission | RLS | 28.01.17 |

Client: Calico

Job: Whitworth Trust Care Home

Drawing: Illustrative Market Street Elevation Comparison

Ref: P3751_SK_48 Re: A

Date: 01/19/17 Scale: 1 : 100 @ A1

Author: RLS Approver:

Feasibility: Tender Construction
Design: Contract As Built



London House
115 Golden Lane
London
EC1Y 0TJ
+44 202 787 0079
architects@pozzoni.co.uk

Woodville House
2 Woodville Road
Altrincham
WA14 2FH
+44 161 928 7848
www.pozzoni.co.uk